



3.10.2026

111 Congress Marquee Sign revision

Project description:

The project consists of adding the business logo to the top of the previously approved marquee and on the sides which were previously changeable letter fields. The original marquee height, size and other design factors are the same except for the logo addition added to the top. This placement was inspired by other historic marquee signs, most notably the Lucas Theatre for the Arts.






Red indicates the sign/logo location. See sign cut sheets for greater detail.

SUBMITTAL FOR:

NEW METAL CANOPY/MARQUEE SIGN
FOR

STANDARD LOUNGE
CHANGE 1 (JTVS)

111 W CONGRESS ST.
SAVANNAH, GA 31401

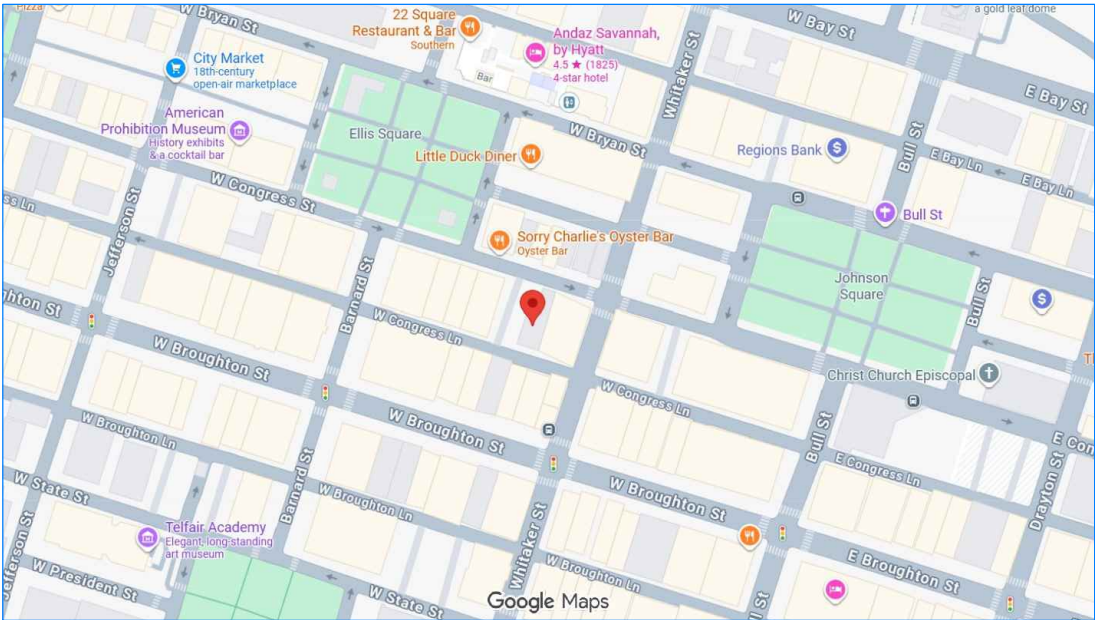

GENERAL NOTES:



COASTAL CANVAS
PRODUCTS

1674 CHATHAM PARKWAY
SAVANNAH, GEORGIA 31405
MAIN: 912 236 2416 FAX: 912 232 7884
WWW.COASTALCANVAS.NET



SUBMITTAL REVIEW

- ☐ **APPROVED**
EXECUTION MAY PROCEED AS SHOWN.
- ☐ **APPROVED AS NOTED**
EXECUTION MAY PROCEED BASED ON NOTES INDICATED.
- ☐ **APPROVED AS NOTED WITH FILE COPY**
EXECUTION MAY PROCEED BASED ON NOTES INDICATED.
CORRECT SUBMISSION TO RESUBMIT FOR RECORD PURPOSES ONLY.
- ☐ **NOT APPROVED**
RESUBMIT FOR APPROVAL.
- ☐ **REVIEW FOR INFORMATION**
APPROVAL NOT REQUIRED. ACCEPTED FOR INFORMATION ONLY.

SIGNATURE:

DATE:

THIS DRAWING IS THE PROPERTY OF CCP CO., INC. AND
MAY BE USED ONLY IN CONNECTION WITH OUR WORK.
ANY AS SPECIFIED BY CCP CO., INC. UNAUTHORIZED
USE OR REPRODUCTION IS STRICTLY PROHIBITED

REVIEWED BY

FRONT, SIDE, PLAN
&
ISOMETRIC FRAME VIEW

DRAWN BY
A WEBB

DATE
03-02-26

JOB NUMBER
260173



COASTAL CANVAS
PRODUCTS

1674 CHATHAM PARKWAY SAVANNAH, GEORGIA 31405
MAIN: 912 236 2416 FAX: 912 232 7884 WWW.COASTALCANVAS.NET

NEW METAL CANOPY/MARQUEE SIGN
FOR
STANDARD LOUNGE
CHANGE 1 (JTVS)
111 W CONGRESS ST.
SAVANNAH, GA 31401

CHATHAM

MARCH 2026


SCALE

NONE

REVISION	DATE	REASON

SHEET NO.

COVER

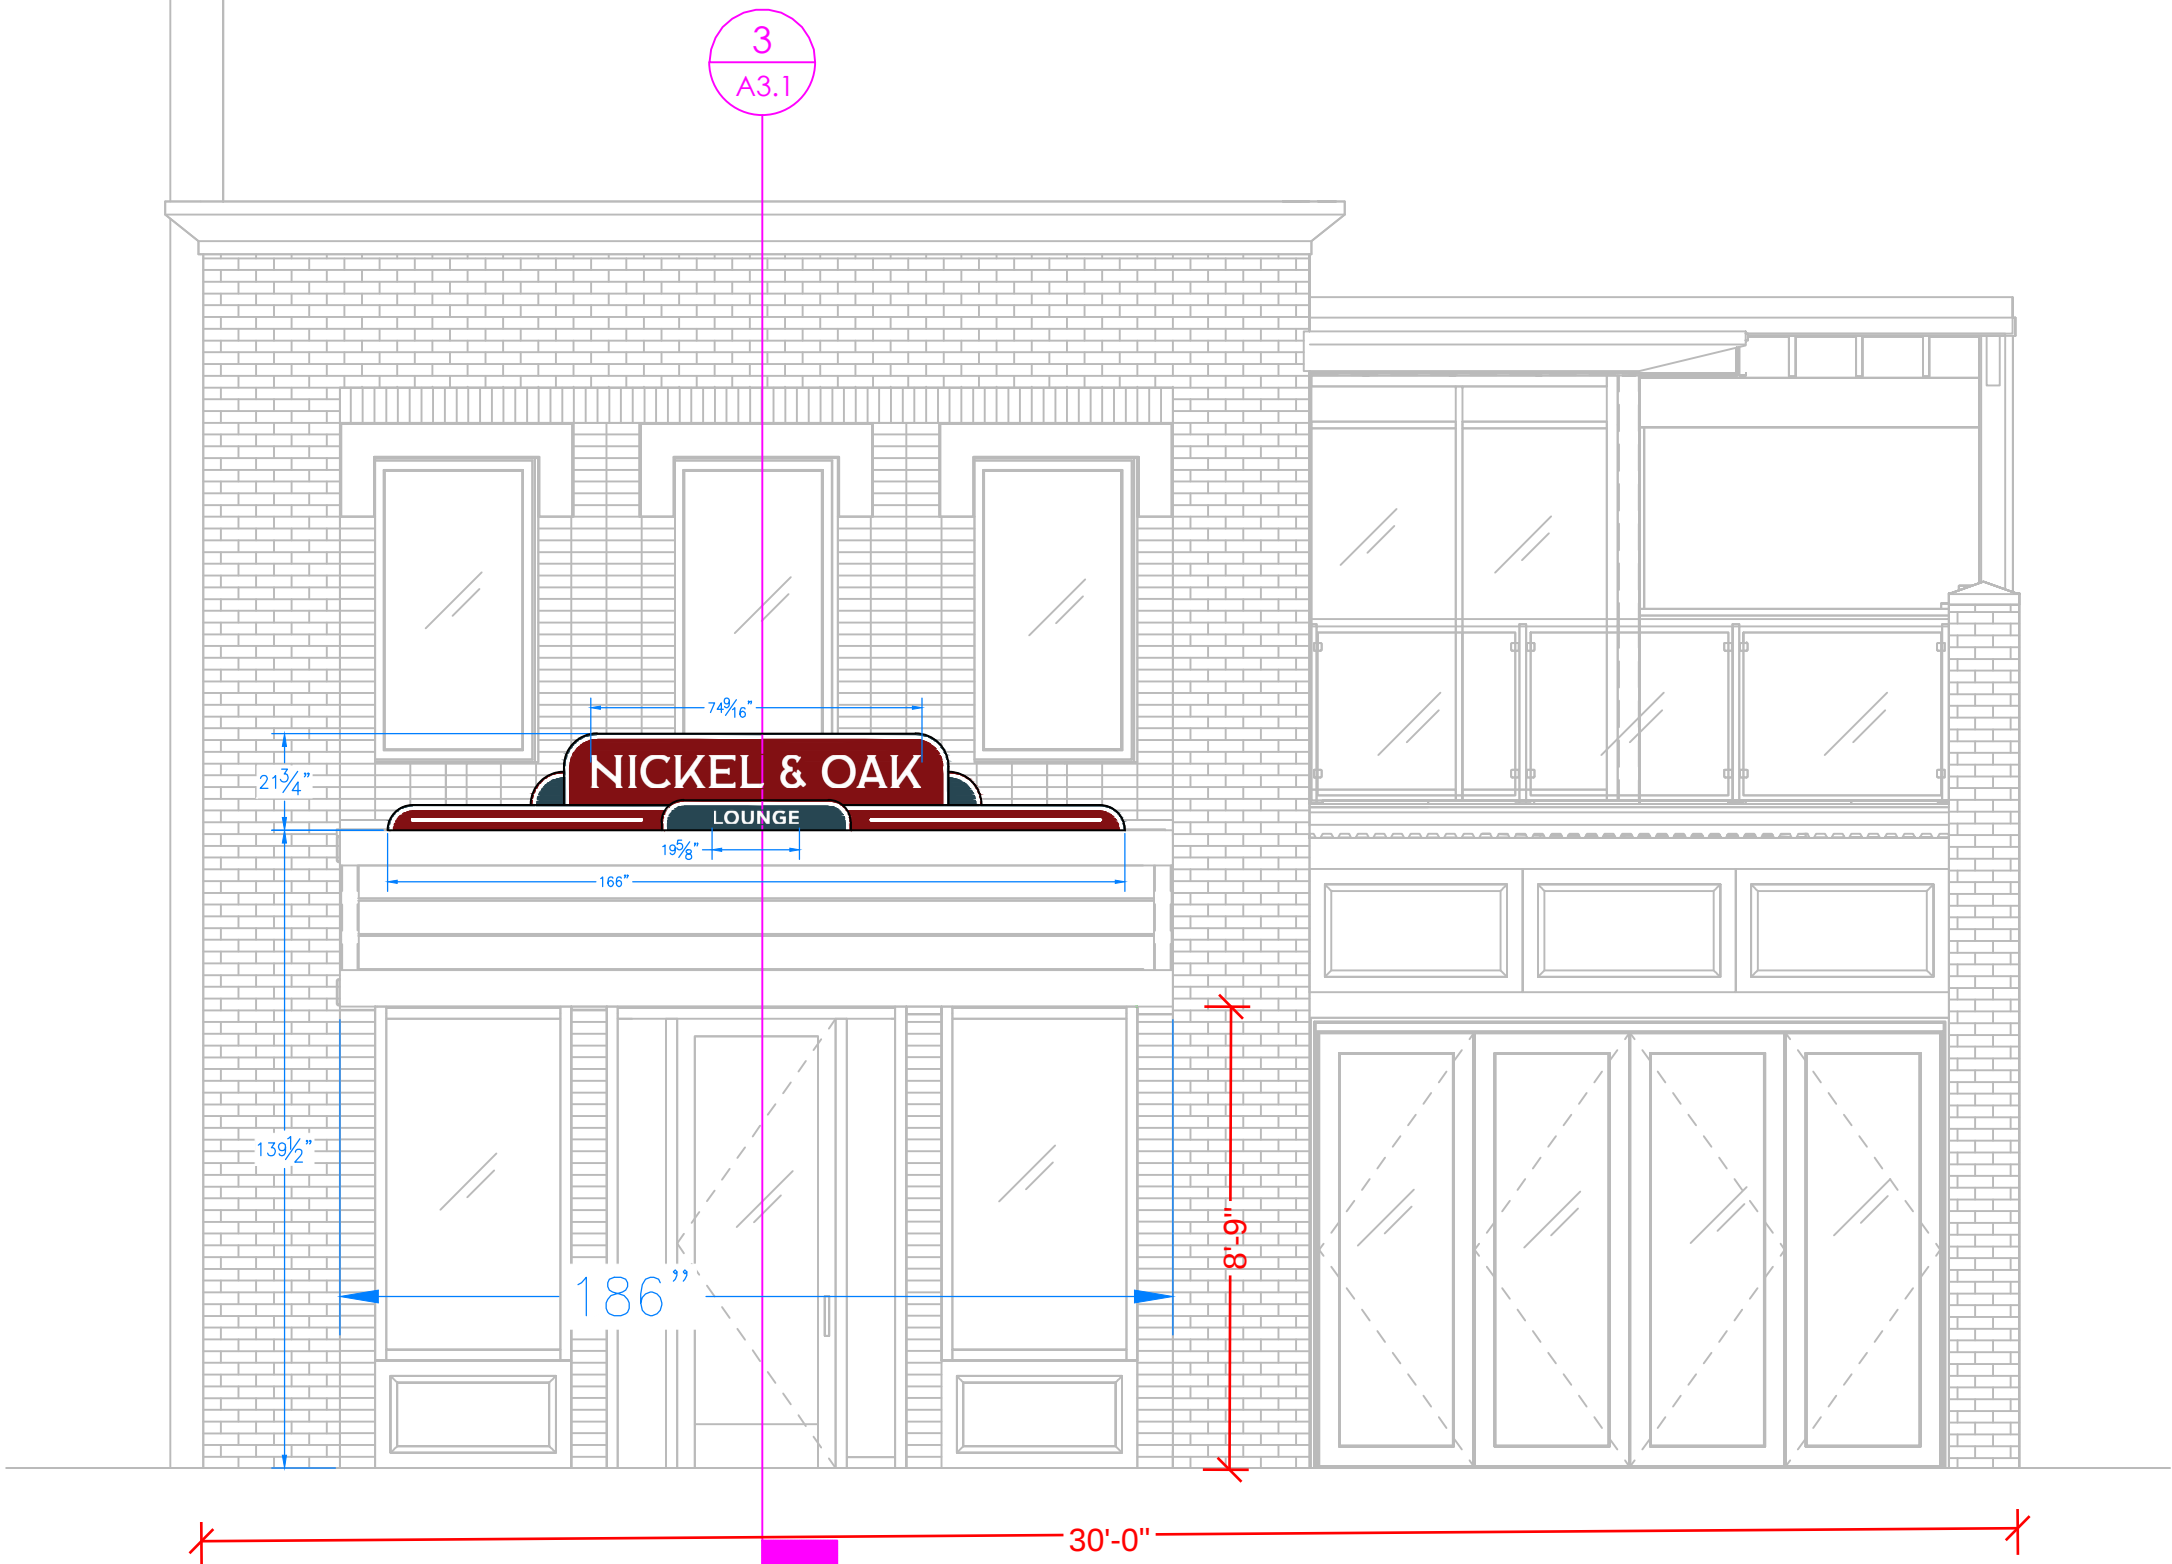

1
A2.0

ELEVATION - NORTH - CONGRESS STREET

THIS DRAWING IS THE PROPERTY OF CCP CO., INC. AND
MAY BE USED ONLY IN CONNECTION WITH OUR WORK.
AND AS SPECIFIED BY CCP CO., INC. UNAUTHORIZED
USE OR REPRODUCTION IS STRICTLY PROHIBITED

REVIEWED BY

FRONT, SIDE, PLAN
&
ISOMETRIC FRAME VIEW

DRAWN BY
A WEBB

DATE
03-02-26

JOB NUMBER
260173



1674 CHATHAM PARKWAY SAVANNAH, GEORGIA 31405
MAIN: 912.236.2416 FAX: 912.232.7884 WWW.COASTALCANVAS.NET

NEW METAL CANOPY/MARQUEE SIGN
FOR
STANDARD LOUNGE
CHANGE 1 (JTVS)

111 W CONGRESS ST.
SAVANNAH, GA 31401

MARCH 2026

CHATHAM


SCALE

NONE

REVISION	DATE	REASON

SHEET NO.



E1

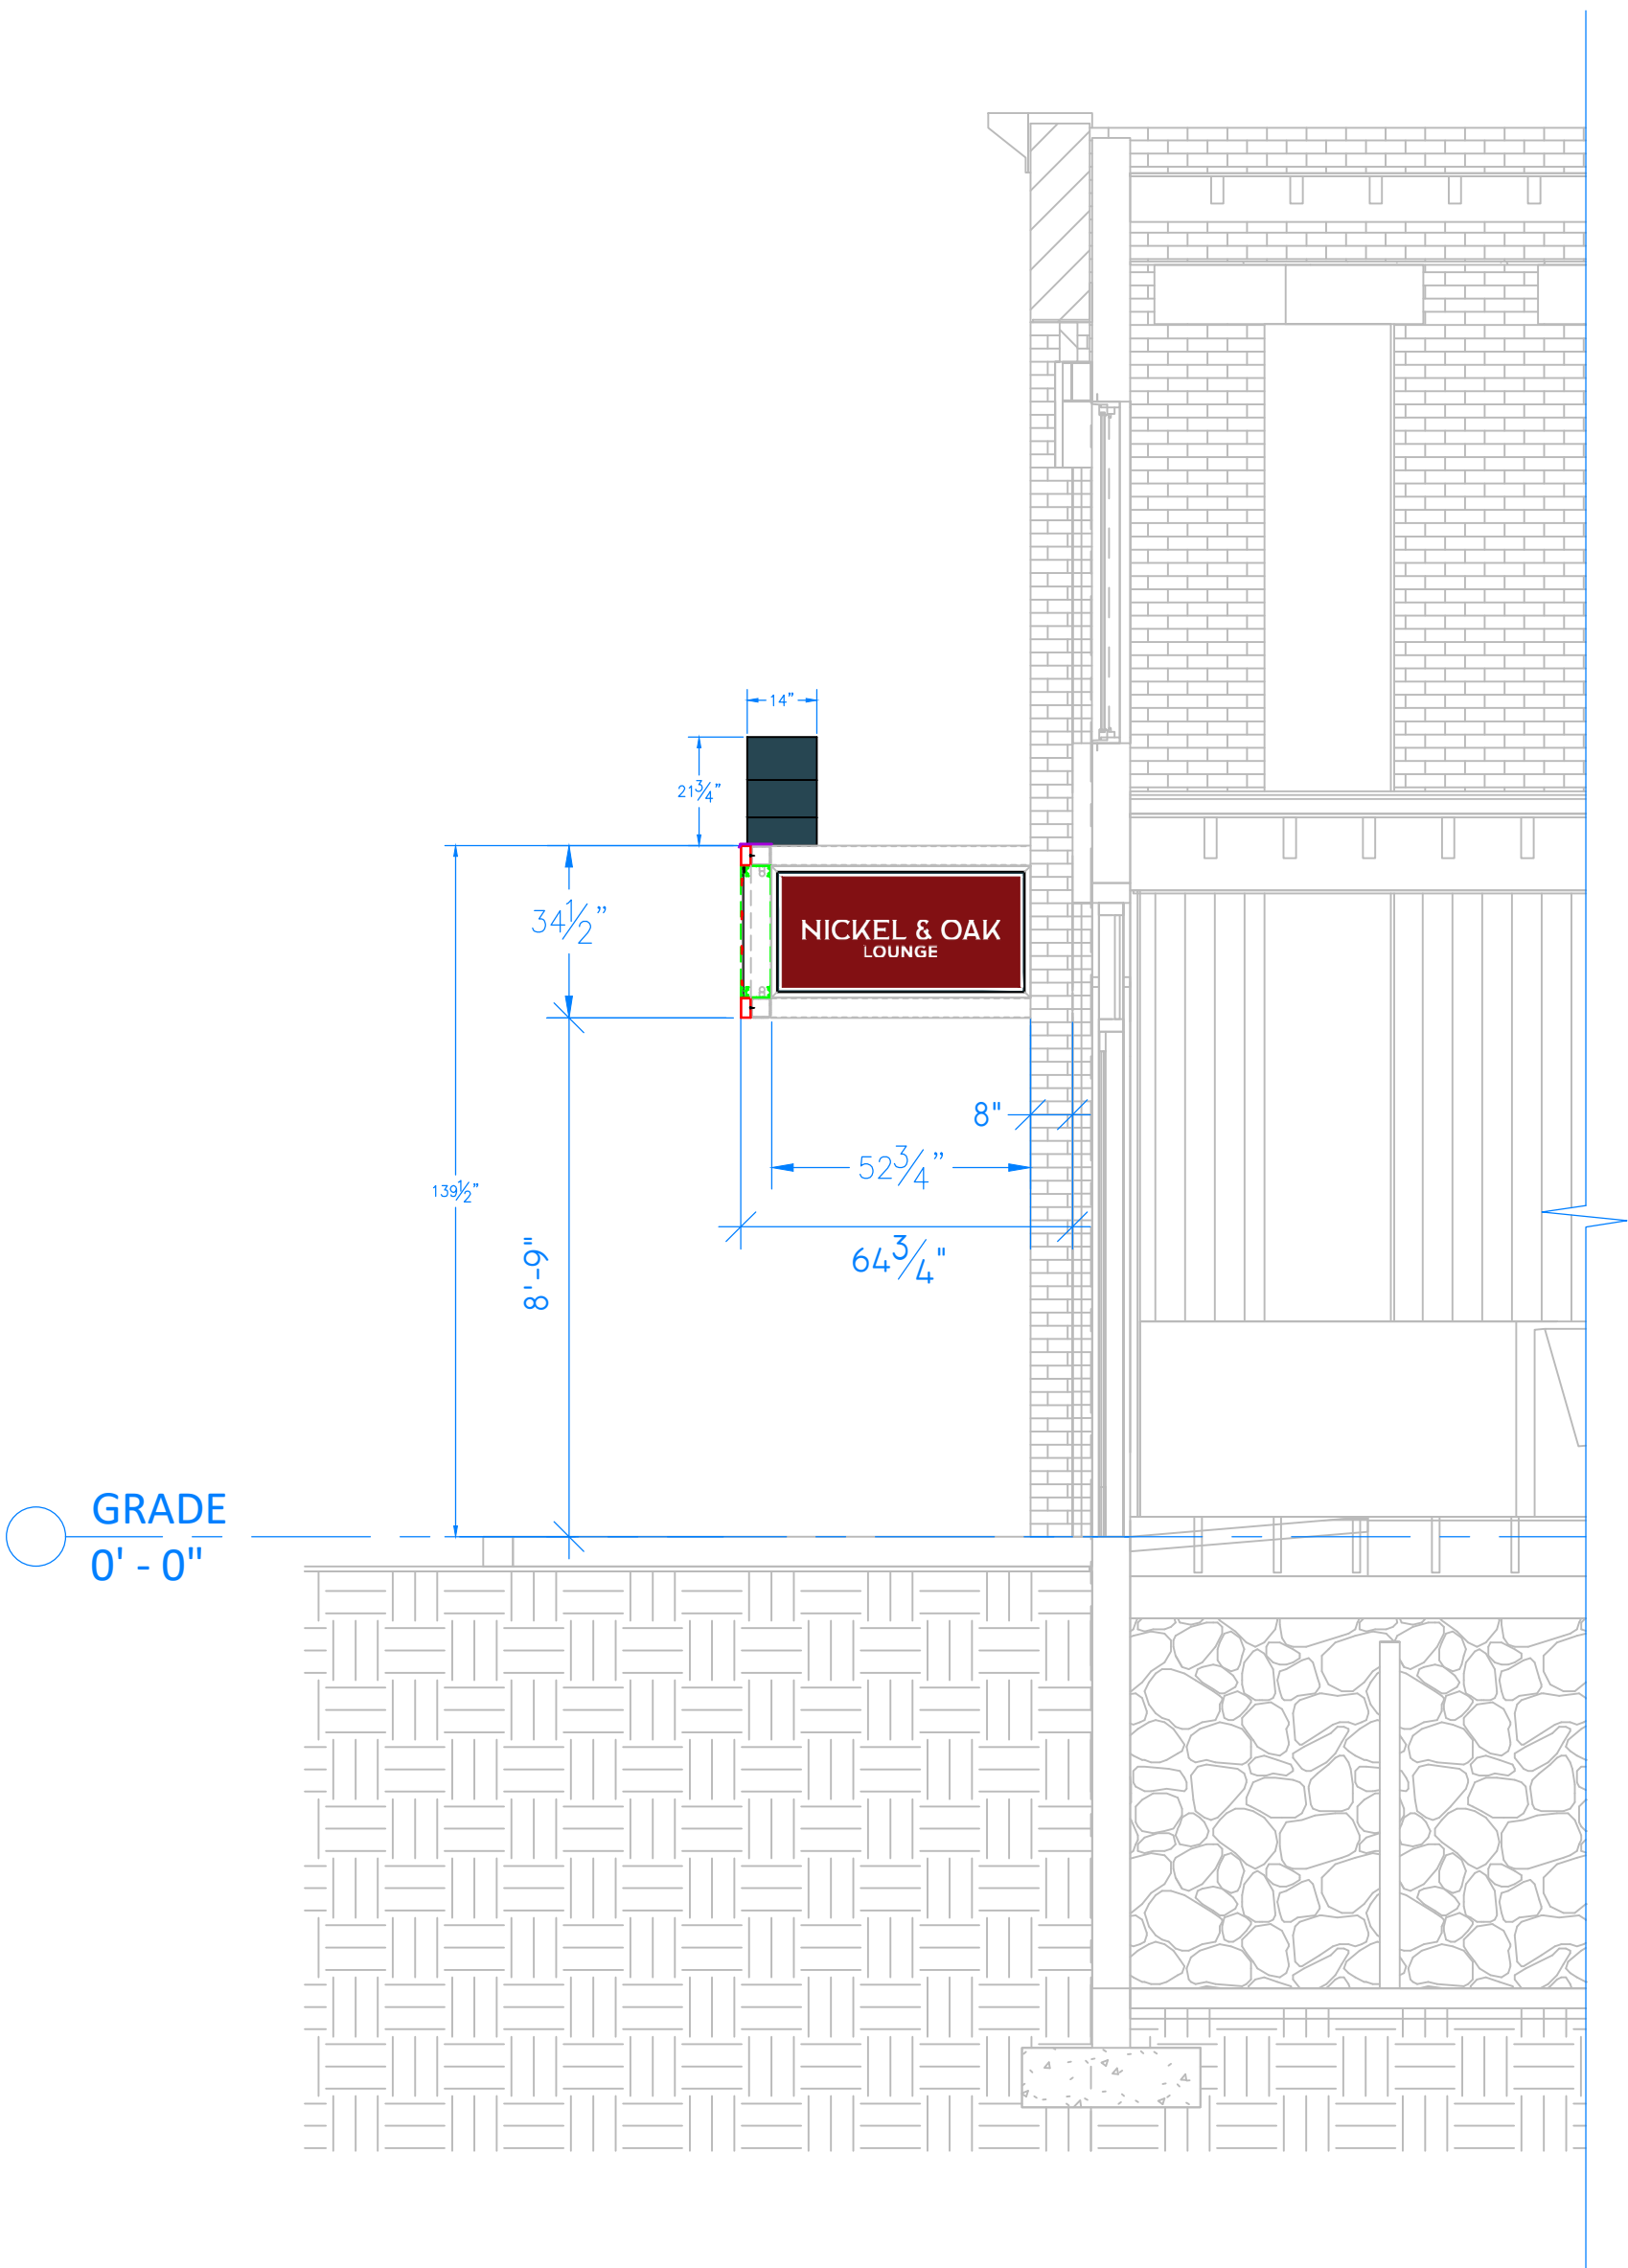

3 BUILDING SECTION 3
A3.1

E2	SHEET NO.	REVISION	NONE		SCALE	NEW METAL CANOPY/MARQUEE SIGN			FRONT, SIDE, PLAN & ISOMETRIC FRAME VIEW			THIS DRAWING IS THE PROPERTY OF CCP CO., INC. AND MUST BE USED ONLY IN CONNECTION WITH OUR WORK, AND AS SPECIFIED BY CCP CO., INC. UNAUTHORIZED USE OR REPRODUCTION IS STRICTLY PROHIBITED	
		DATE				FOR							
						STANDARD LOUNGE CHANGE 1 (JTVS)						REVIEWED BY	
						111 W CONGRESS ST.							
						SAVANNAH, GA 31401							
DRAWN BY			DATE			JOB NUMBER							
A WEBB			03-02-26			260173							
 COASTAL CANVAS PRODUCTS													
1674 CHATHAM PARKWAY SAVANNAH, GEORGIA 31405 MAIN: 912 236 2416 FAX: 912 232 7884 WWW.COASTALCANVAS.NET													
CHATHAM						MARCH 2026							

- NOTES:
- A. SIGNS ARE 3M GERBER VINYL CUTOUT AND ADHERED TO WHITE LEXAN POLYCARBONATE
 - B. VINYL IS 3M GERBER TRANSLUCENT 230:
#230-53 (CARDINAL)
#230-36 (DARK BLUE)
 - C. PERIMETER OF TOP SIGN IS .080 ALUMINUM SHEETMETAL
 - D. BACK OF SIGN IS .125 ALUMINUM SHEET METAL
 - E. SHEET METAL BOX POWDERED RAL #5001 (GREEN BLUE)
 - F. SIGN ATTACHES TO MARQUEE WITH TEK SCREWS
 - G. LED LIGHTS MOUNTED TO INSIDE OF SHEET METAL ENCLOSURE BEHIND LEXAN

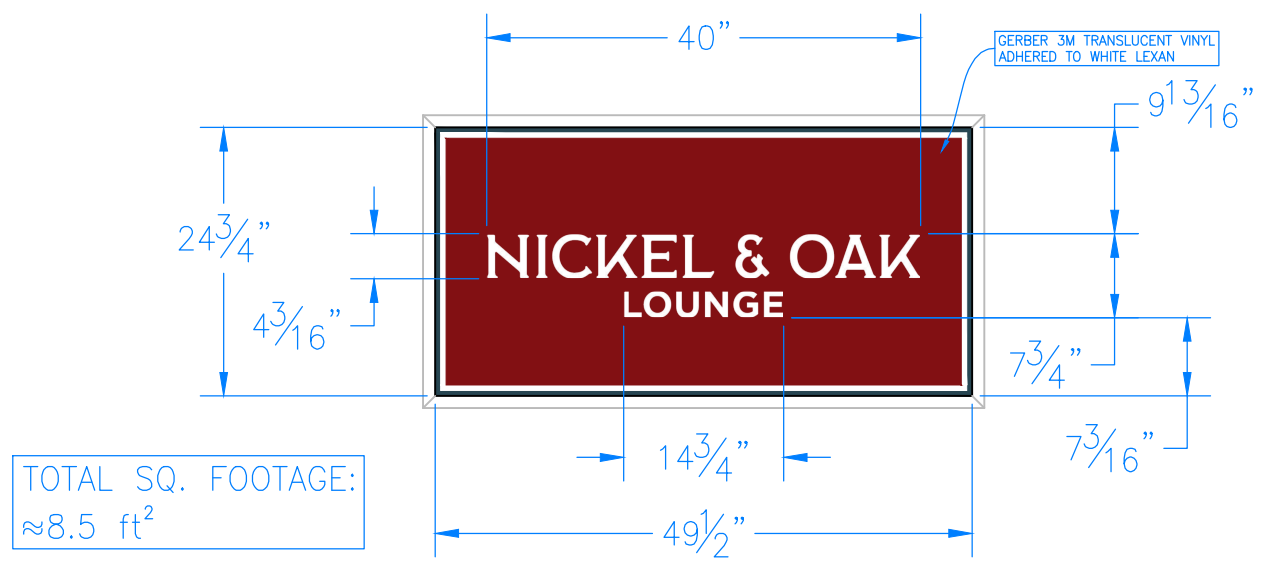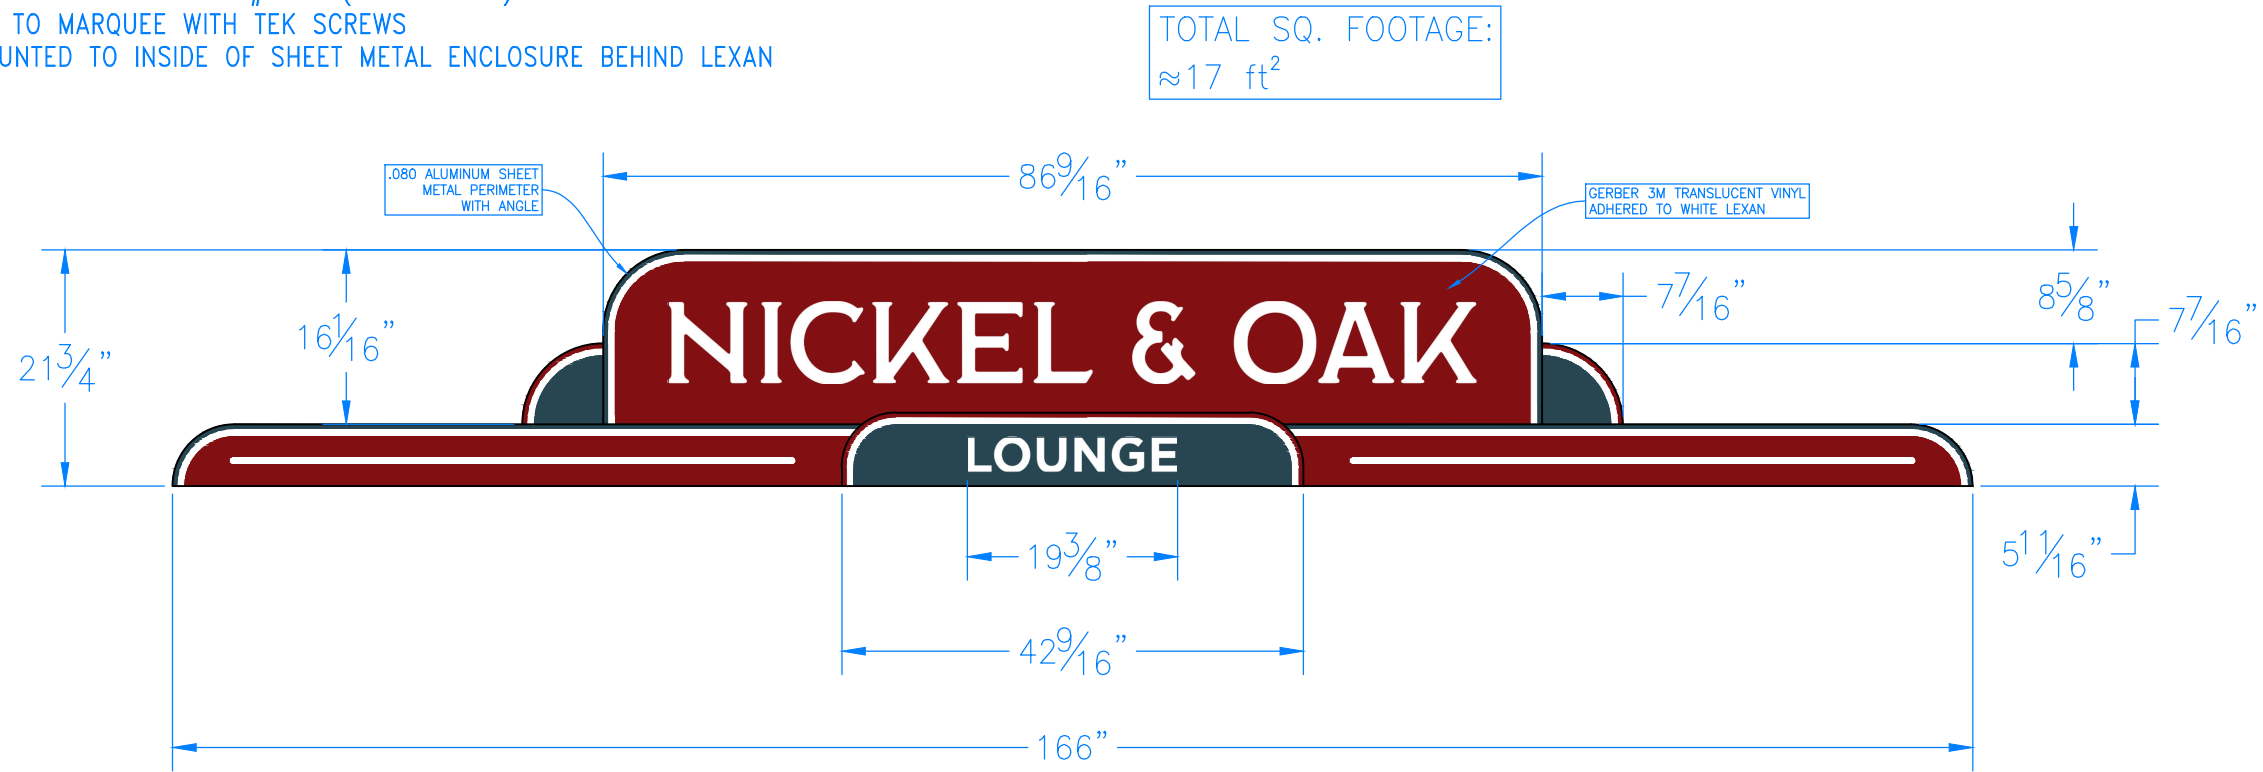

TOTAL SQ. FOOTAGE:
≈17 ft²

TOTAL SQ. FOOTAGE:
≈8.5 ft²

THIS DRAWING IS THE PROPERTY OF CCP CO., INC. AND MUST BE USED ONLY IN CONNECTION WITH OUR WORK, AND AS SPECIFIED BY CCP CO., INC. UNAUTHORIZED USE OR REPRODUCTION IS STRICTLY PROHIBITED

REVIEWED BY

FRONT, SIDE, PLAN & ISOMETRIC FRAME VIEW

DRAWN BY: A WEBB
DATE: 03-02-26
JOB NUMBER: 260173

COASTAL CANVAS PRODUCTS

1674 CHATHAM PARKWAY SAVANNAH, GEORGIA 31405
MAIN: 912.236.2416 FAX: 912.232.7884 WWW.COASTALCANVAS.NET

NEW METAL CANOPY/MARQUEE SIGN FOR

STANDARD LOUNGE CHANGE 1 (JTVS)

111 W CONGRESS ST. SAVANNAH, GA 31401

CHATHAM

MARCH 2026

SCALE

NONE

REVISION	DATE	REASON

SHEET NO.

DETAIL